




Available Properties in Downtown Plymouth, MI

Office Space



Ann Arbor Trail and Main Street (Mayflower Center)

Call Jeff Gosselin: (734) 272-1262
Suite 408, 416 and 424

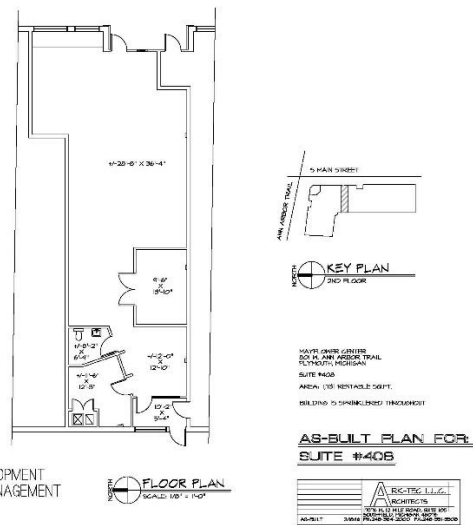


RSM DEVELOPMENT & MANAGEMENT
P.O. BOX 3073
BIRMINGHAM, MICHIGAN 48212
(248) 645-2600

FLOOR PLAN
SCALE: 1/8" = 1'-0"


AS-BUILT PLAN FOR SUITE #408

ARCHITECT
1000 PLYMOUTH TRAIL, SUITE 100
PLYMOUTH, MI 48170
PH: 734.272.1262 FAX: 734.272.1263


Suite 408

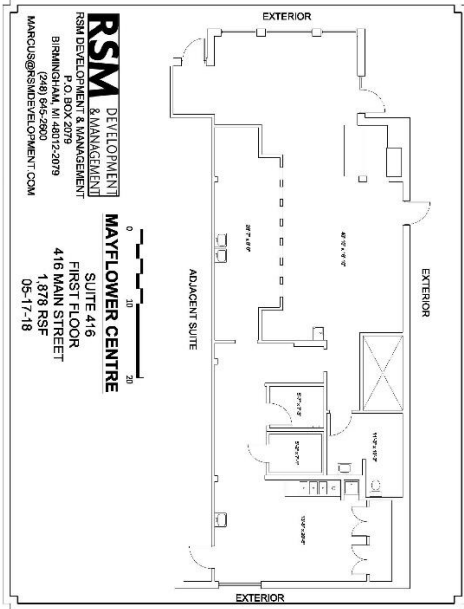

Suite 416

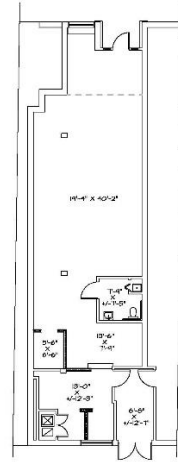

Suite 424

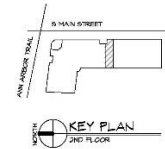

MAST JONES CENTRE
200 W. MAIN STREET TRAIL
PLYMOUTH, MICHIGAN
SUITE #424
AREA: 1,580 RENTABLE SQFT.
BUILDING IS SPRINKLERED THROUGHOUT

AS-BUILT PLAN FOR
SUITE #424

RSM DEVELOPMENT & MANAGEMENT
P.O. BOX 3075
BIRMINGHAM, MICHIGAN 48217
248 645-2620

FLOOR PLAN
SCALE: 1/8" = 1'-0"

AS-BUILT
SCALE: 1/8" = 1'-0"



Pastel Plymouth 447 Forest Ave. , Suite 1

Office Spaces- Share Workspaces & Private

Private Offices Available

Call for more information: (734) 404-8232

Email: hello@pastelplymouth.com

<http://www.pastelplymouth.com>



206 S. Union

1400 square feet office space
Contact Bake Real Estate at 734-272-8375



292 South Main

Approximately 925 SF
This is an upstairs office space
Asking \$2000/mo gross rent
Contact John at 734.216.1932



Downtown
PLYMOUTH



Not Just a Walk in the Park



Retail Space



983 W. Ann Arbor Tr. Suite 17

800 sq. ft. first floor

700 sq. ft. 2nd floor

Asking 20.00 per sq. ft. gross, plus utilities

Available November 1

Contact Vince at 734-453-4555